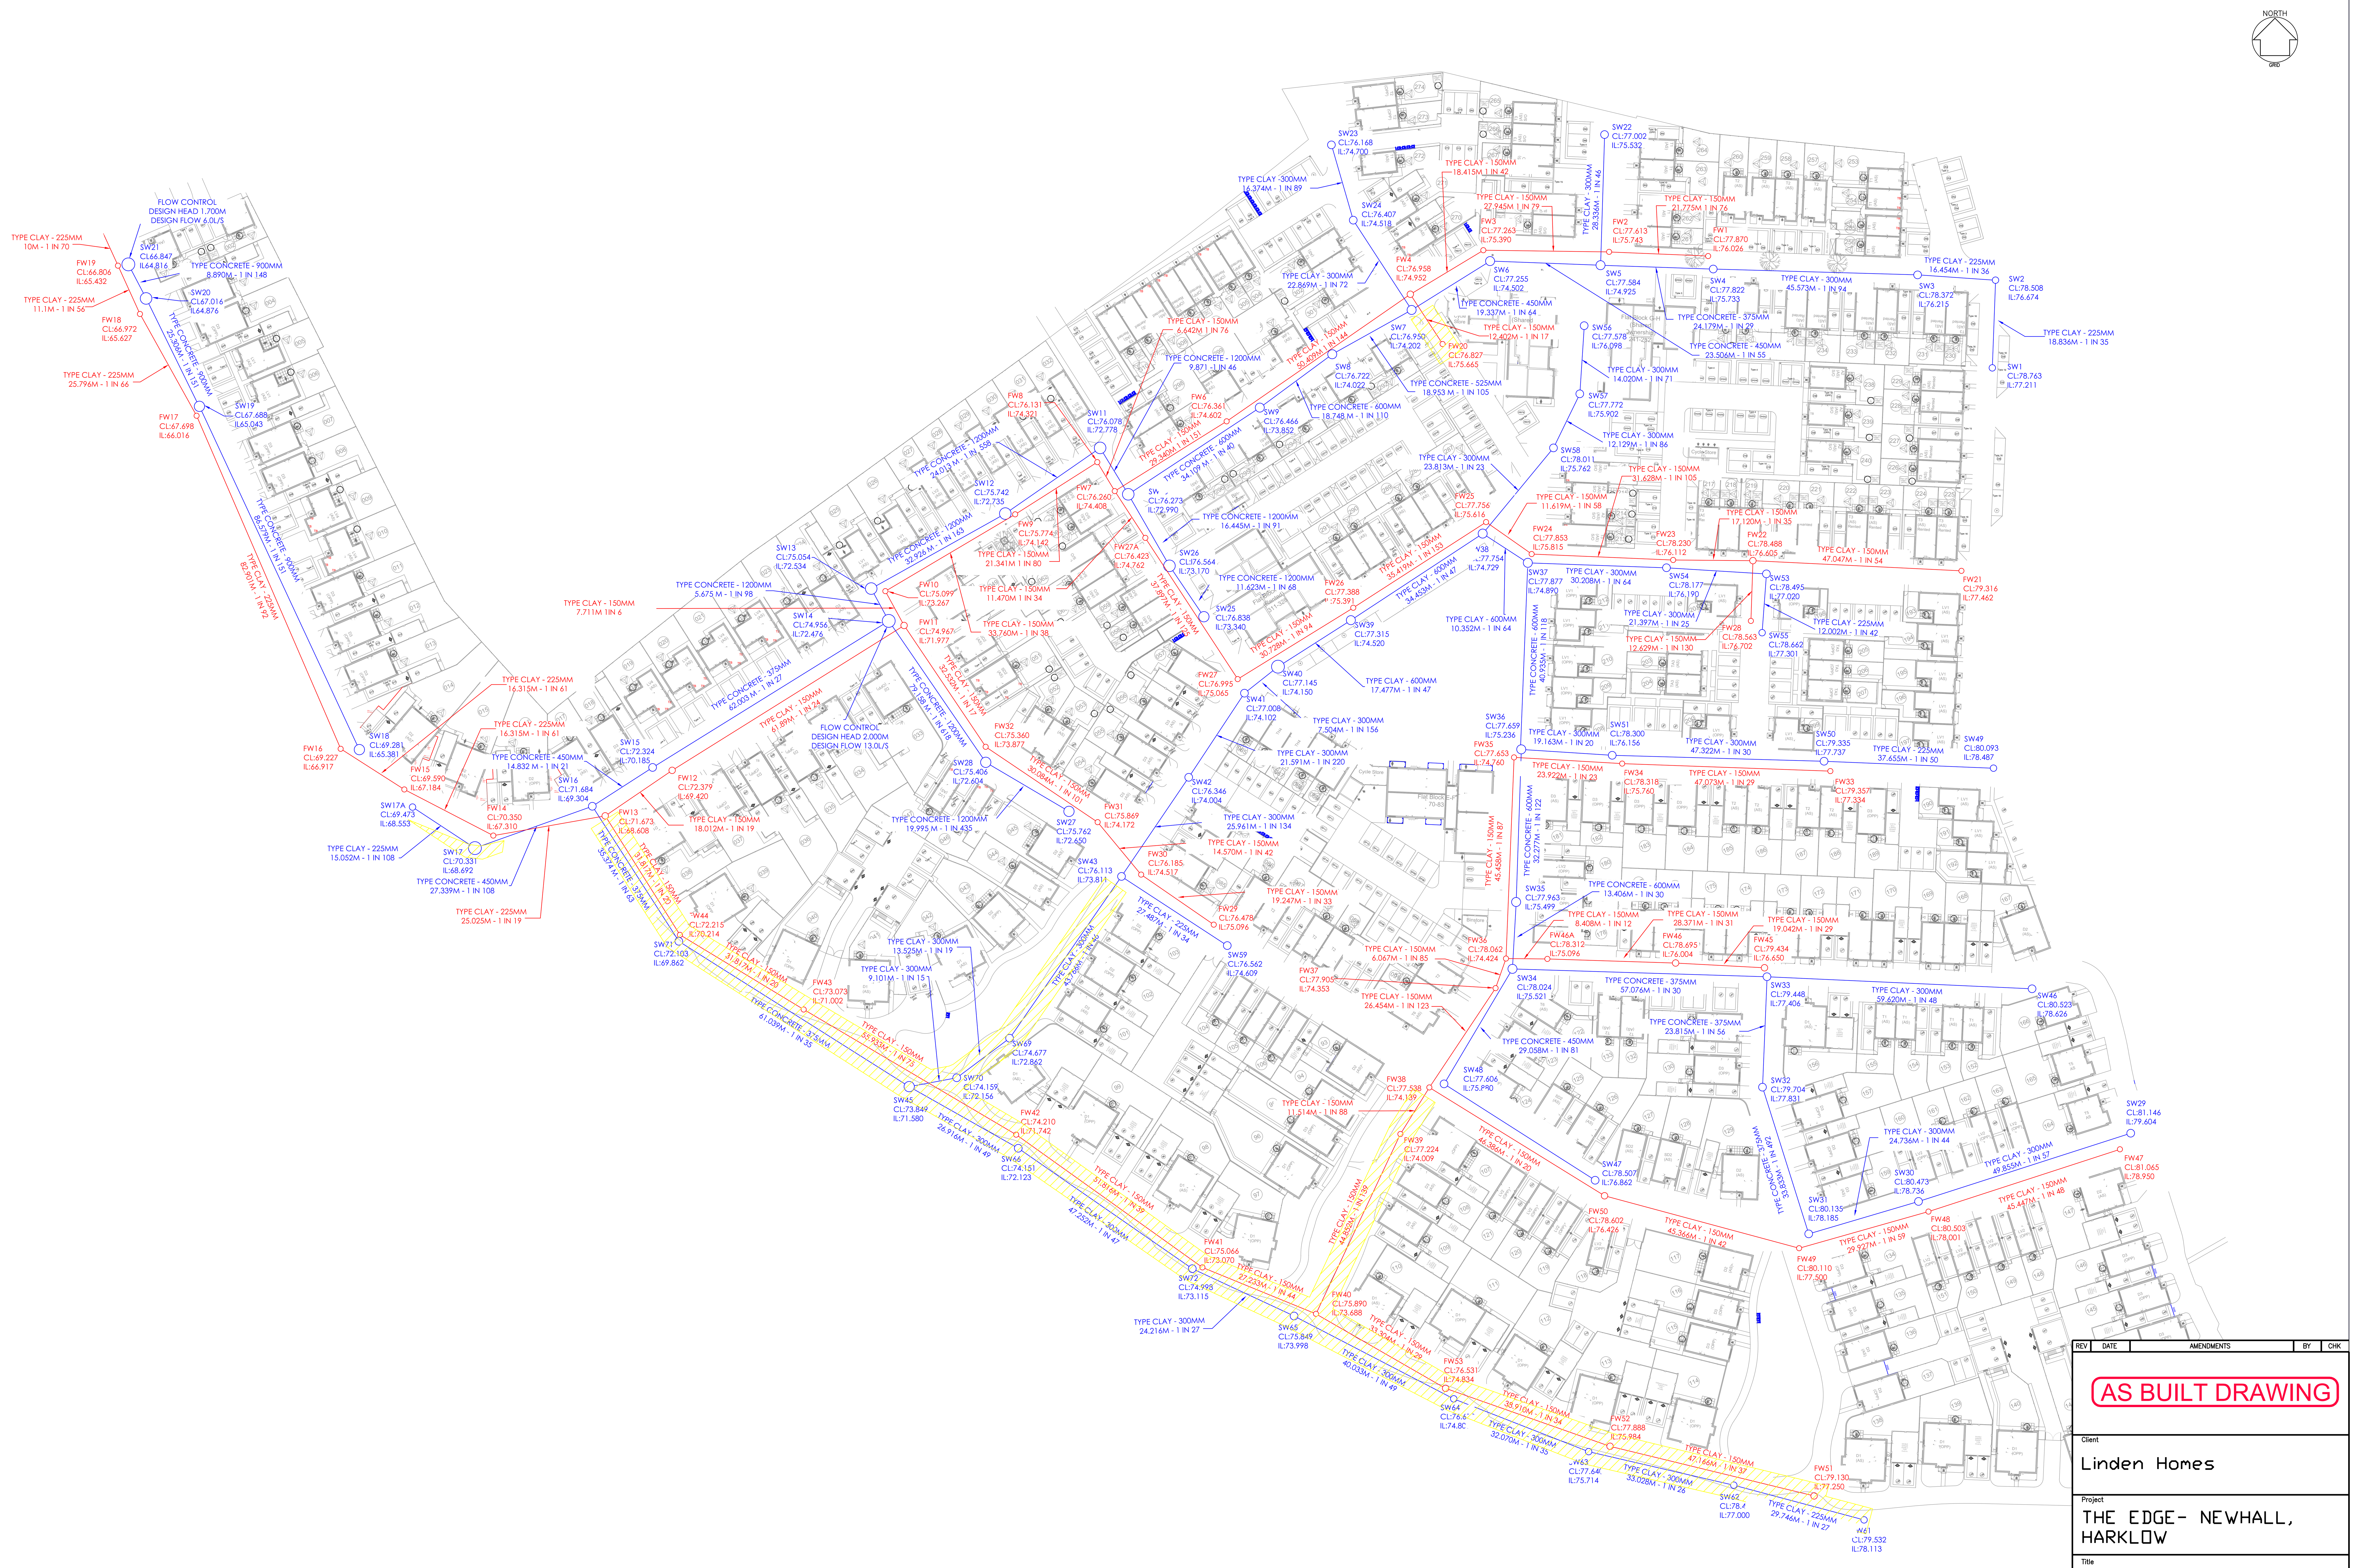

REV	DATE	AMENDMENTS	BY	CHK

AS BUILT DRAWING

Client
Linden Homes

Project
THE EDGE- NEWHALL, HARKLOW

Title
Section 102
AS BUILT

Drawn	Checked	Status	Scale
RDJ		AS BUILT	1:200@A1

Date	Drawing No.
JUNE 2021	LHE108 - 102